


LED SEQUENCER

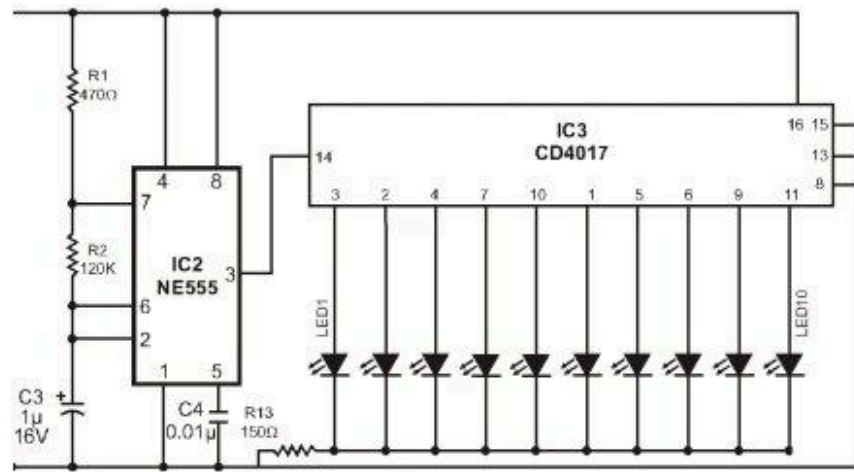

as built:

R1: 470k
R2: 220k
C3: 0.1uf
C4: 0.01uf
R13: 220ohm

for 6 LED flasher pin 15 (Reset)
connected to output 7, which is pin 5.

LED SEQUENCER

for 6 LED flasher pin 15 (Reset) connected to output 7, which is pin 5.