




## AREA VIII PHYSICAL PLANT AND FACILITIES

### S.2.3. good ventilation and lighting

University of Southern Mindanao

AREA VIII: PARAMETER I – ACCREDITATION CENTER

S.2.3. good ventilation and lighting

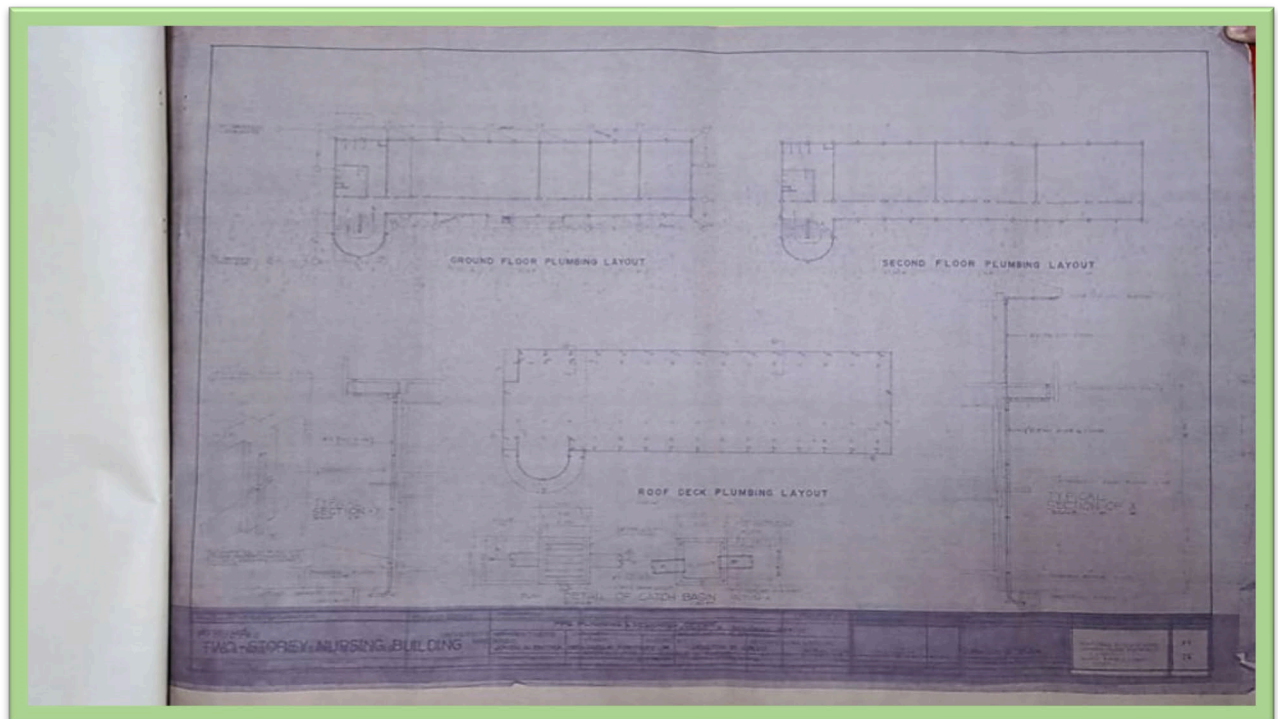

University of Southern Mindanao

AREA VIII: PARAMETER I – ACCREDITATION CENTER




REPUBLIC OF THE PHILIPPINES  
 UNIVERSITY OF SOUTHERN MINDANAO  
**PPDS-PLANNING & DESIGNING OFFICE**  
 KARAGAN, COTABATO


PROJECT TITLE/LOCATION:  
 EXISTING  
**NURSING BUILDING**  
 USM CAMPUS, KARAGAN, COTABATO

CHECKED  
**BENJAMINE FORTINEZ, JR.**  
 DIRECTOR, PPDO


APPROVED  
 DATE: SEPTEMBER 2016  
 DRAWING STATUS: AS BUILT PLAN  
**FRANCISCO GIL N. GARCIA**  
 SUC. PRESIDENT IV

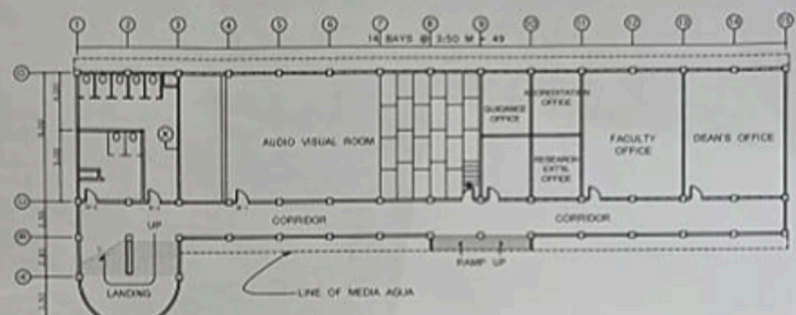

**A2 GROUND FLOOR PLAN**  
 01 | 03 SCALE 1 : 400 M

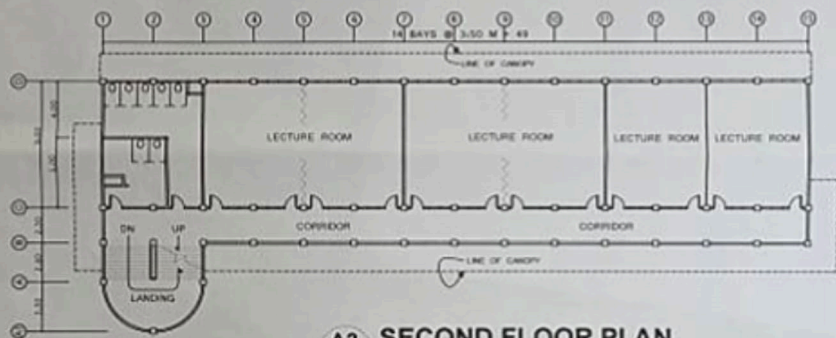

**A2 SECOND FLOOR PLAN**  
 02 | 03 SCALE 1 : 400 M

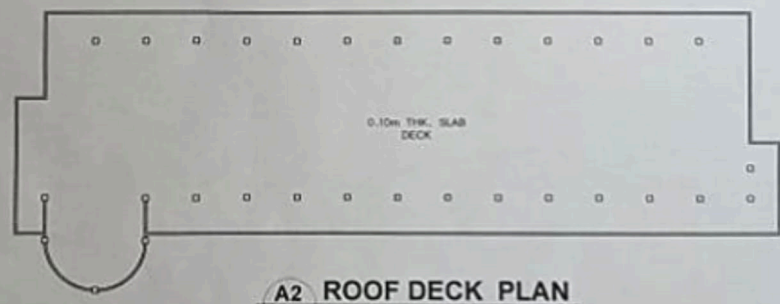


**A2 ROOF DECK PLAN**  
 03 | 03 SCALE 1 : 400 M



University of Southern Mindanao

AREA VIII: PARAMETER I – ACCREDITATION CENTER

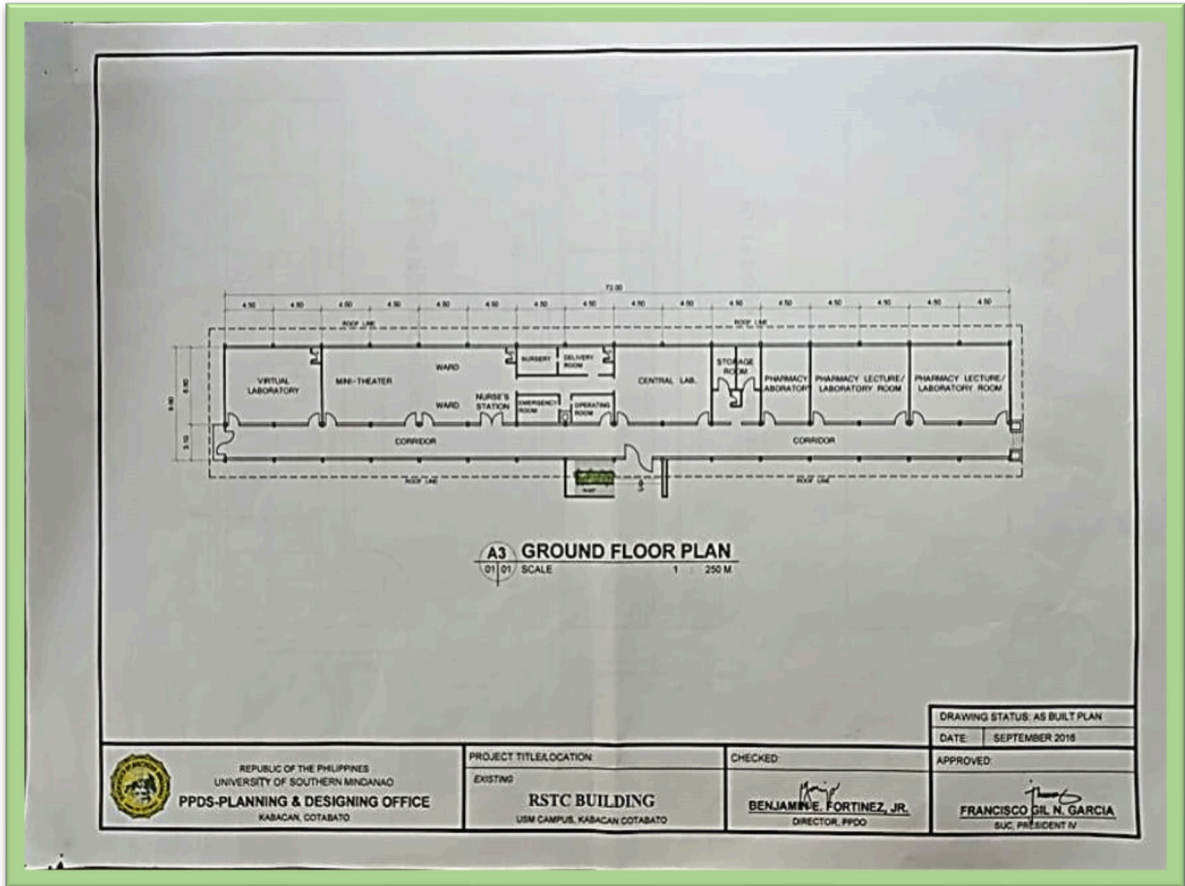

University of Southern Mindanao

AREA VIII: PARAMETER I – ACCREDITATION CENTER